

DRAWING REVISIONS		REFERENCE DRAWINGS		DESIGN FILE No.		DESIGNED	
REV.	REVISION DESCRIPTION	DRG. No.	DESCRIPTION	CONSTRUCT. No.	DESIGNED	DATE	BY
AA	COUNCIL APPROVAL				AA	18/08/09	JP

THIS WORK WAS PREPARED BY:

SCALE 1:500

ORIGINAL SIZE A1

**KN GROUP PTY LTD**  
CONSULTING ENGINEERS


**Moreton Bay Regional Council**  
CABOOTSURF DISTRICT OFFICE  
2 HASTING STREET CABOOTSURF QLD 4510  
Telephone: (07) 5433 0100  
Fax: (07) 5433 4000

**JOB TITLE**  
163 PETERSEN ROAD  
MORAYFIELD  
"AS CONSTRUCTED" - ROAD AND  
STORMWATER

CSC SUBMISSION REFERENCE	
SD-3010	No. 3 OF 4 PLANS
36474	ASCEN GRID NUMBER
A	REV.





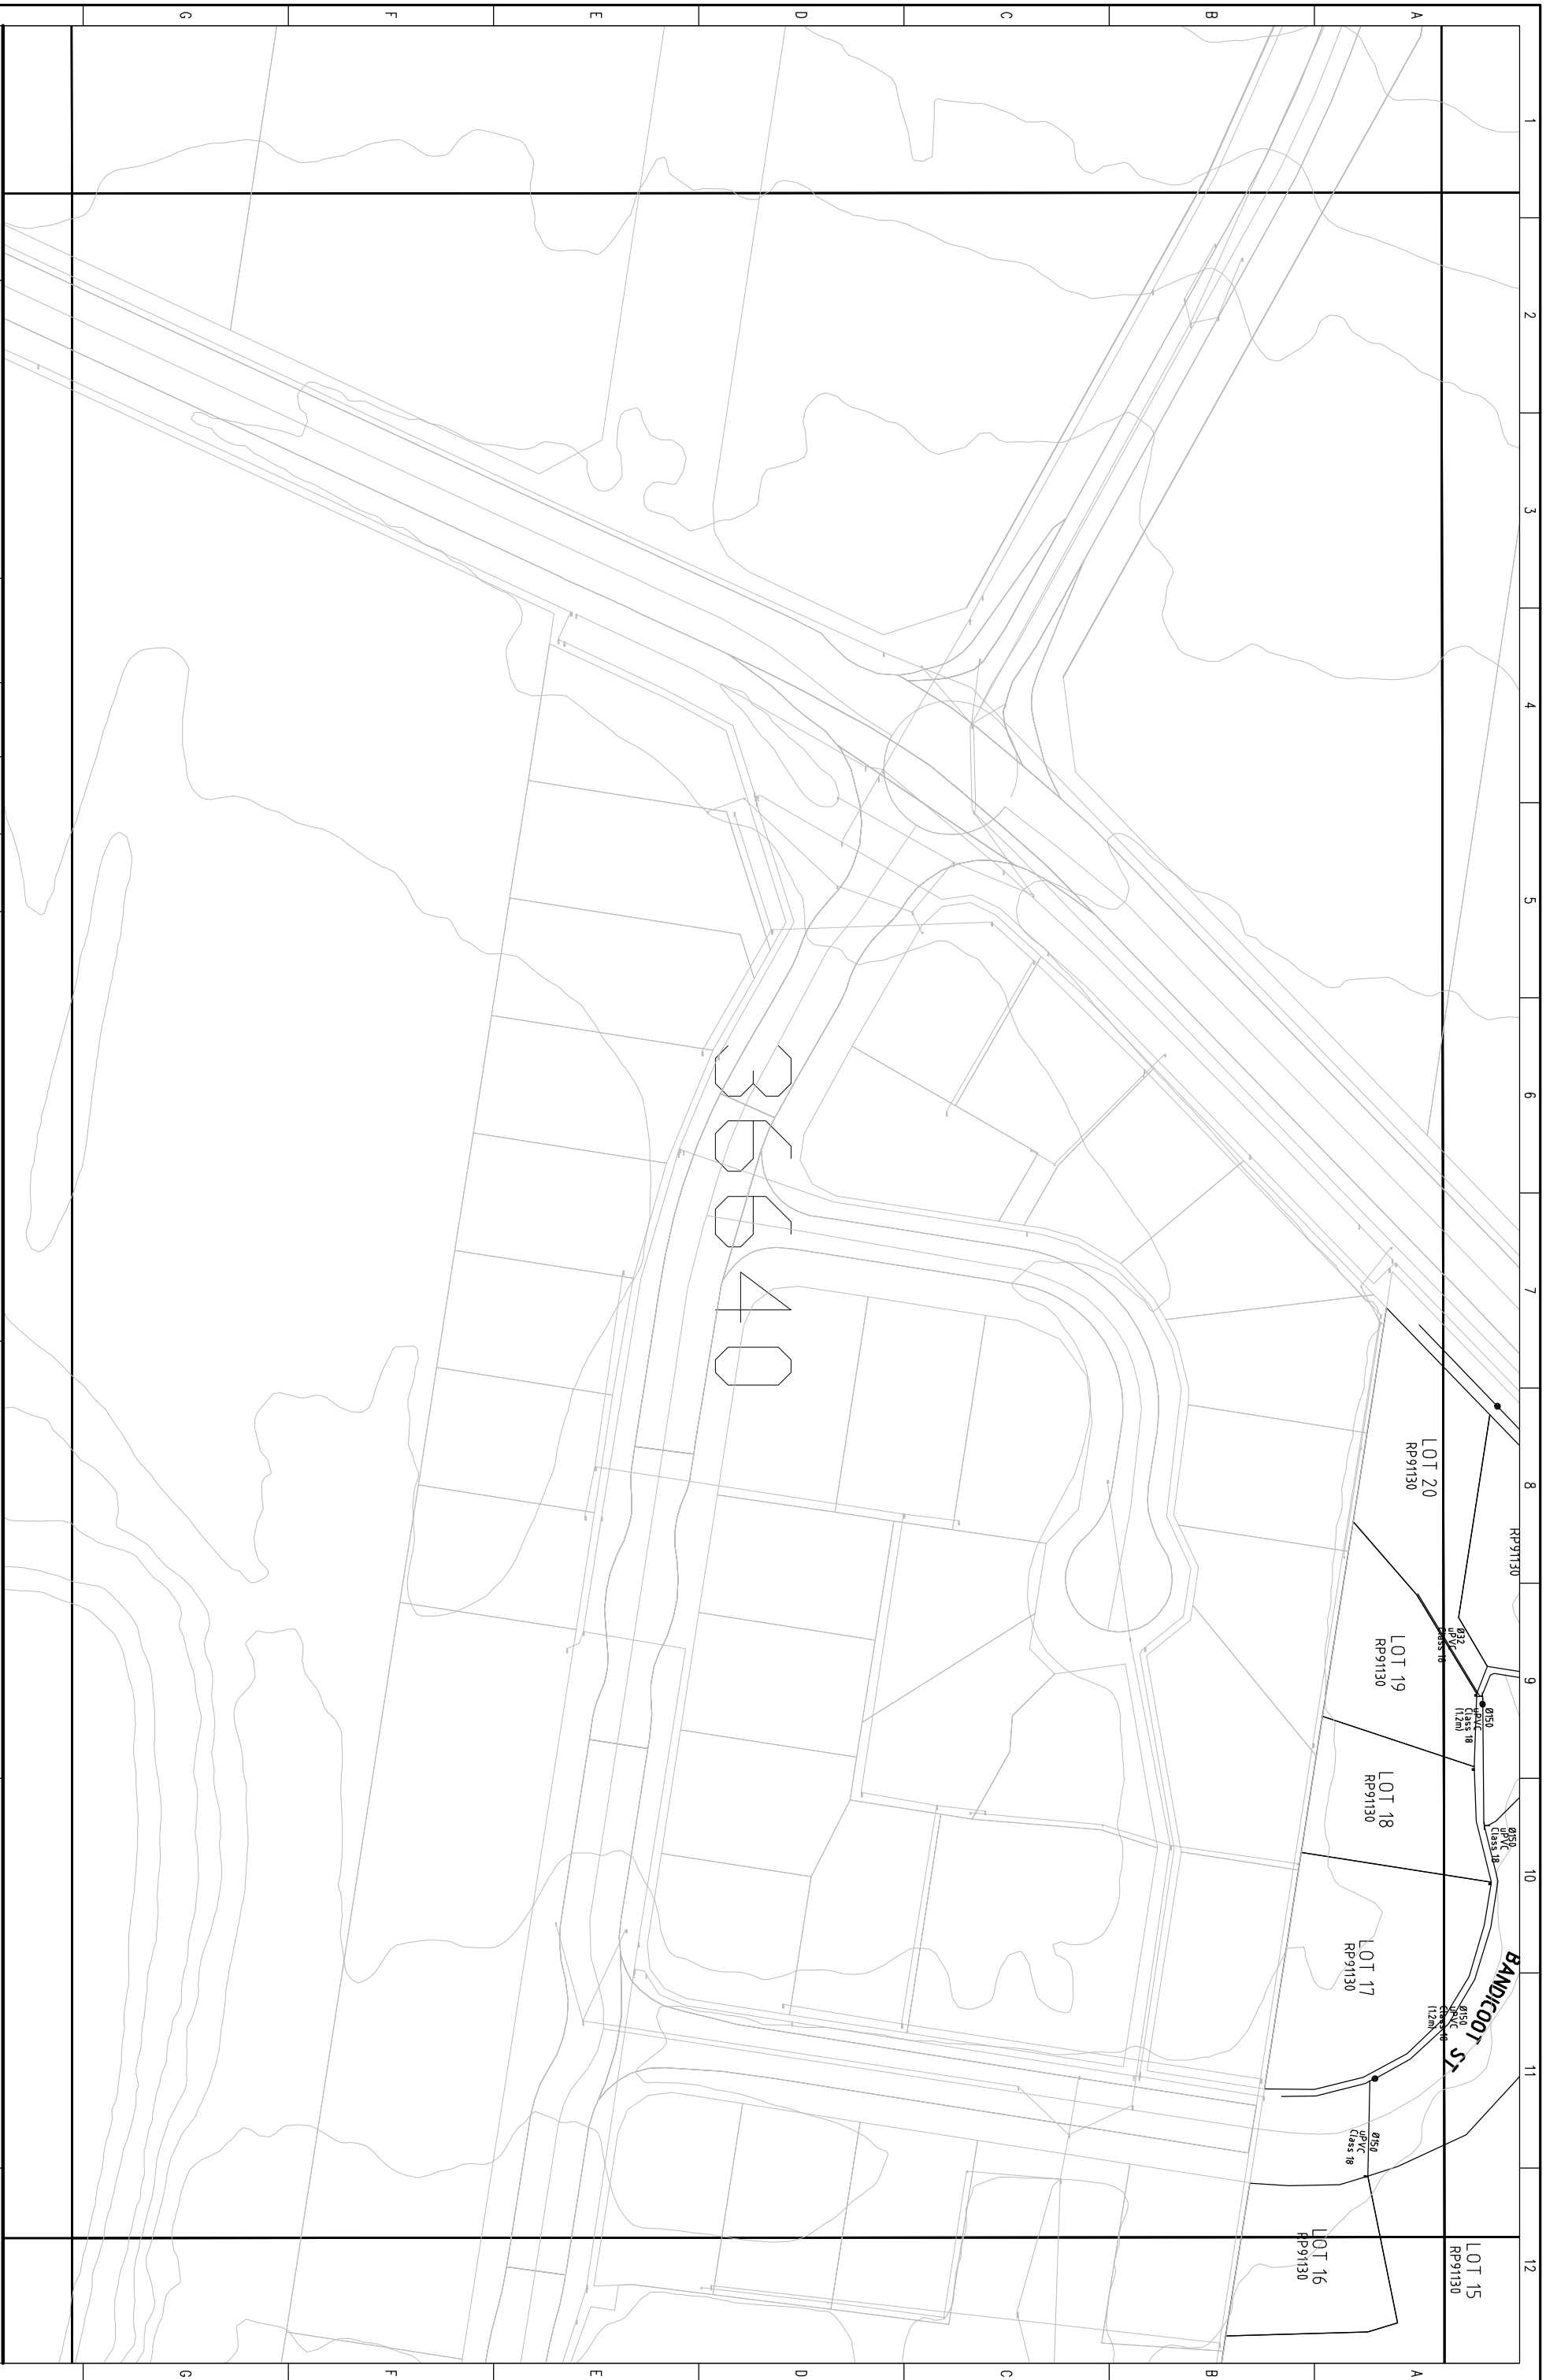


DRAWING REVISIONS		REFERENCE DRAWINGS		DESIGN FILE No.		DESIGNED		THIS WORK WAS PREPARED BY:		JOB TITLE		CSC SUBMISSION REFERENCE	
REV.	REVISION DESCRIPTION	DRG. No.	DESCRIPTION	CONSTRUCT. No.	SURVEY FILE No.	DATE	DATE	KN GROUP Pty Ltd	Moreton Bay Regional Council	163 PETERSEN ROAD	SD 3010	No. 2 OF 4 PLANS	REV.
AA	COUNCIL APPROVAL					18/08/09	18/08/09	KN GROUP Pty Ltd CONSULTING ENGINEERS	MORAYFIELD DISTRICT OFFICE 2 HASTING STREET CABOOLTURE QLD 4510 Telephone: (07) 5433 0100 Fax: (07) 5433 4000	MORAYFIELD		ASCOD GRID NUMBER	
										"AS CONSTRUCTED" - WATER		36640	A

1 2 3 4 5 6 7 8 9 10 11 12

A B C D E F G H

Scale 1:500 ORIGINAL SIZE A1

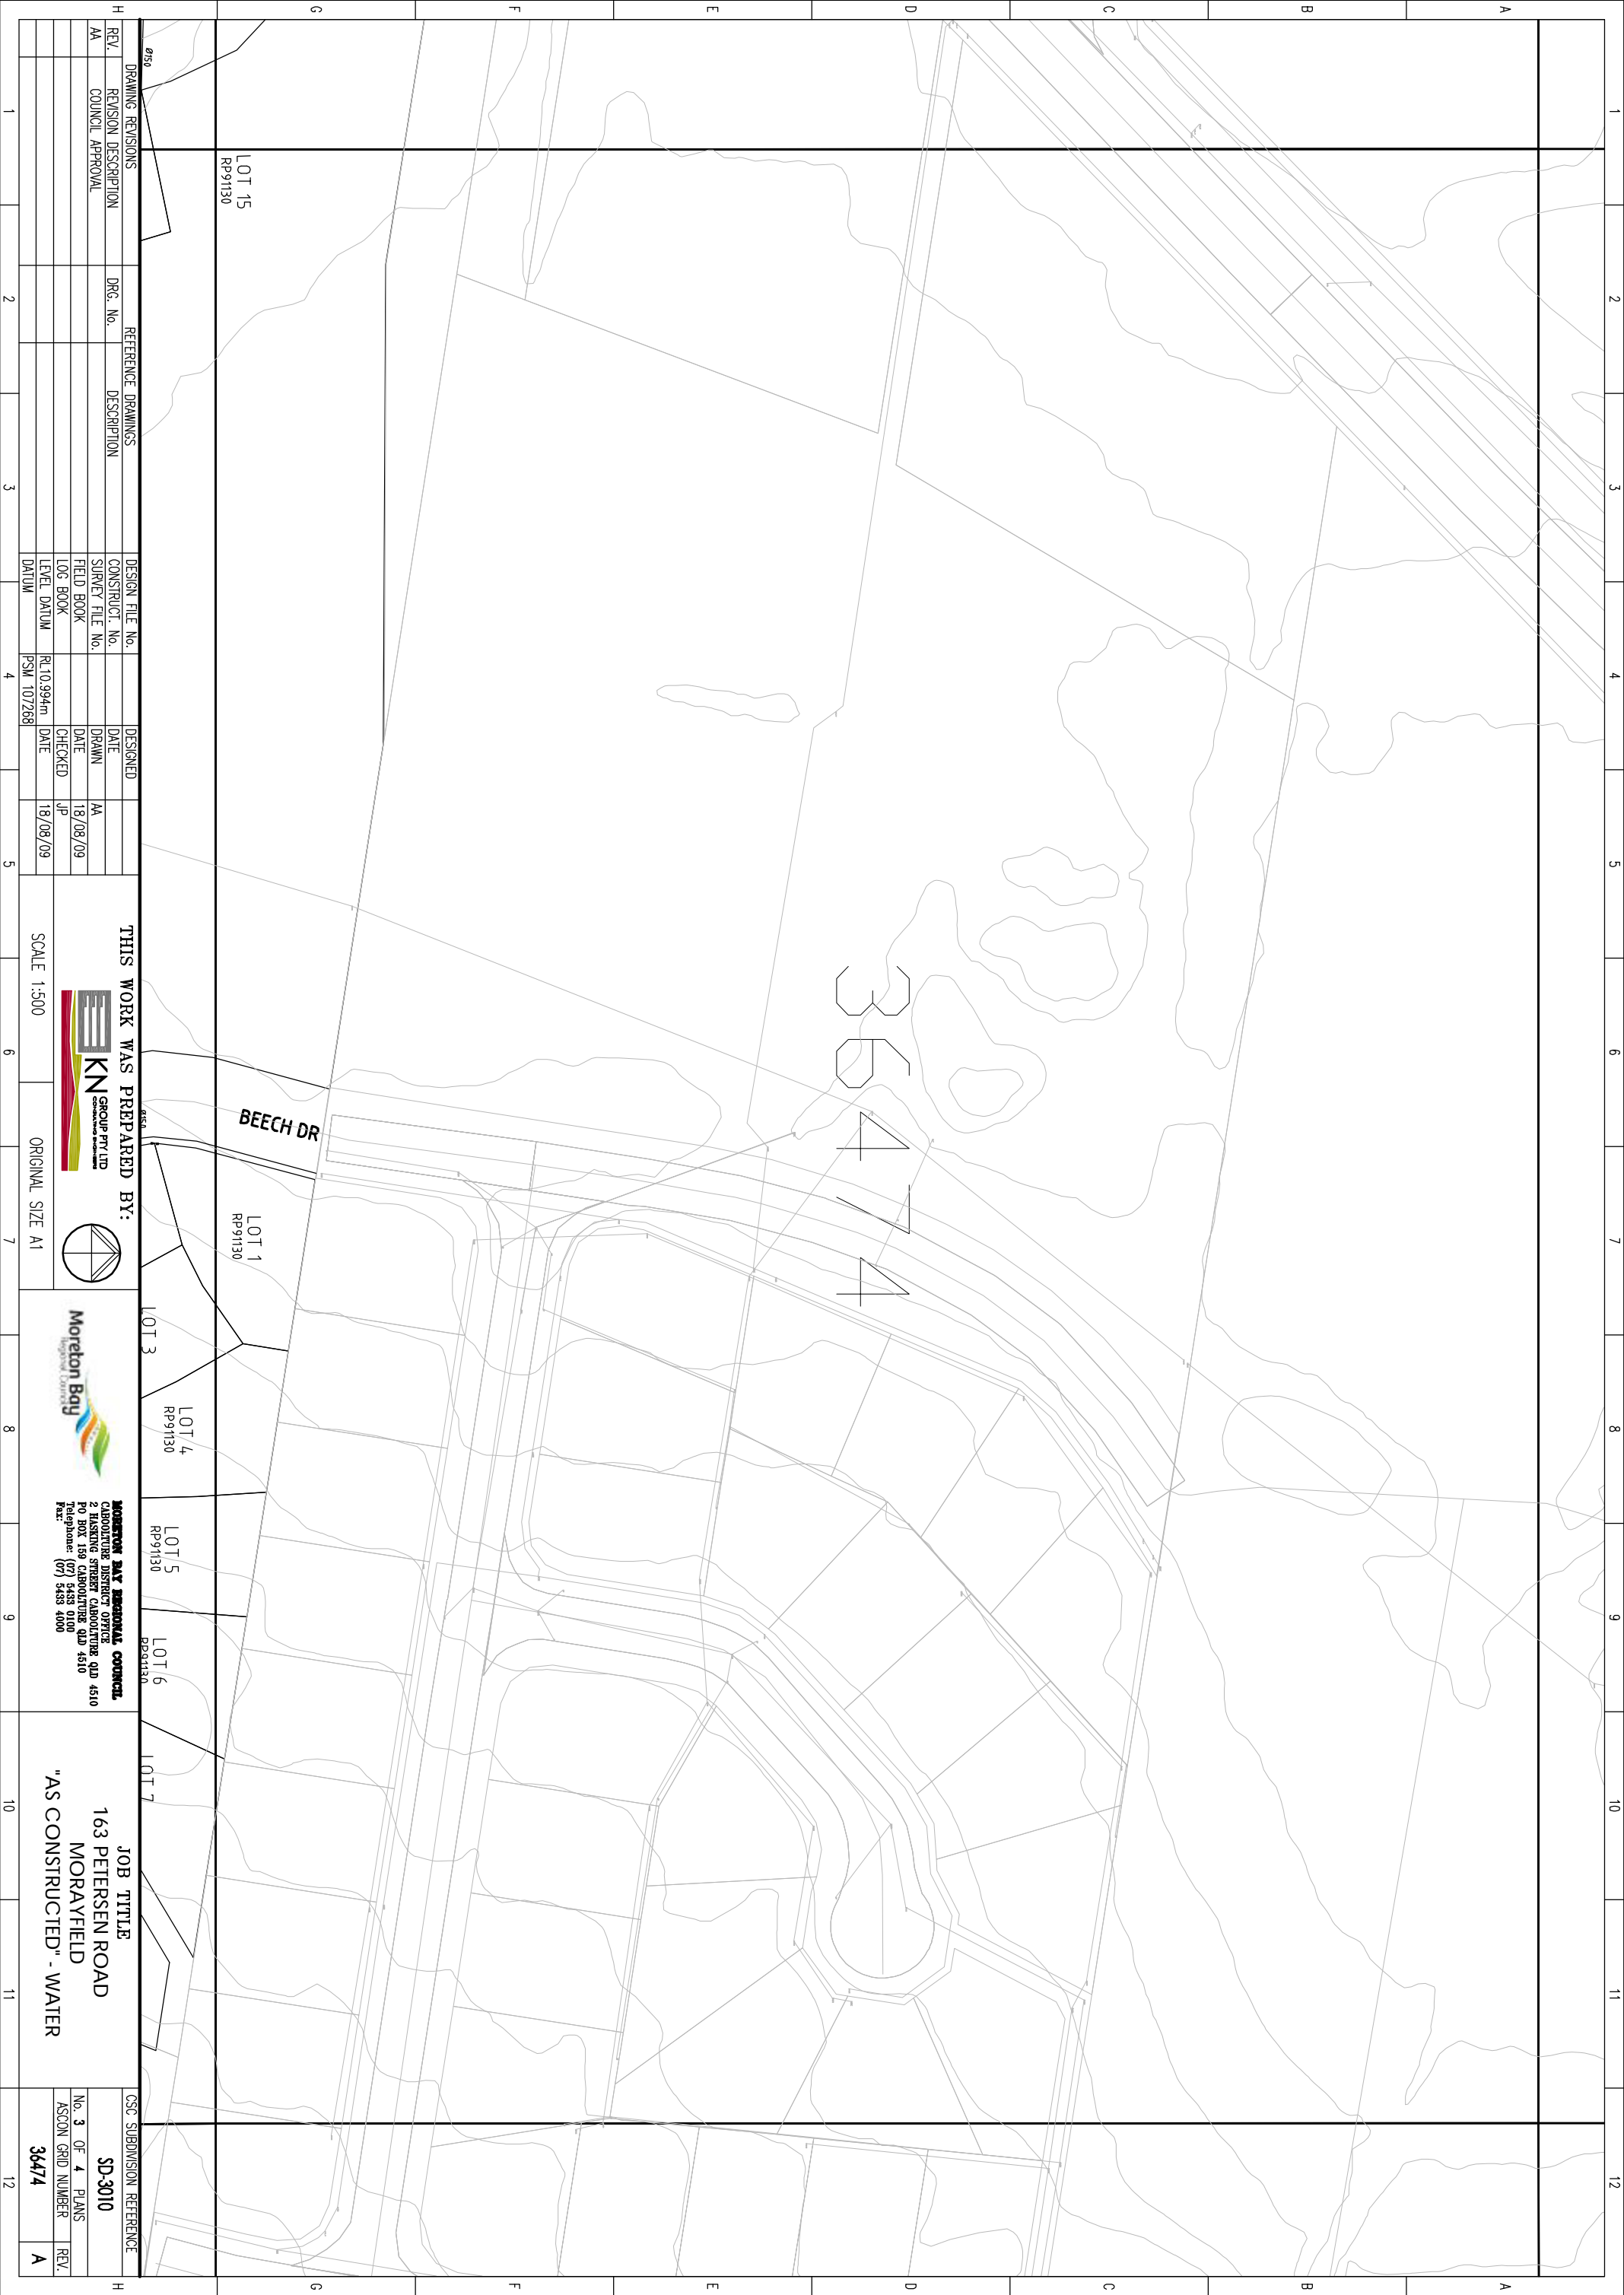

LOT 15  
Rp91130

LOT 1  
Rp91130

LOT 3

LOT 4  
Rp91130

LOT 5  
Rp91130

LOT 6  
Rp91130


LOT 7

BEECH DR

36474

DRAWING REVISIONS		REFERENCE DRAWINGS		DESIGN FILE No.		DESIGNED	
REV.	REVISION DESCRIPTION	DRG. No.	DESCRIPTION	CONSTRUCT. No.	SURVEY FILE No.	DATE	BY
AA	COUNCIL APPROVAL					18/08/09	JA
					LOG BOOK		JP
					LEVEL DATUM		
					PSM 107268		


THIS WORK WAS PREPARED BY:



KN GROUP Pty Ltd  
CONSULTING ENGINEERS

SCALE 1:500

ORIGINAL SIZE A1



**MORETON BAY REGIONAL COUNCIL**  
CABOOTSURF DISTRICT OFFICE  
2 HASTING STREET CABOOTSURF QLD 4510  
Telephone: (07) 5433 0100  
Fax: (07) 5433 4000

**JOB TITLE**  
163 PETERSEN ROAD  
MORAYFIELD  
"AS CONSTRUCTED" - WATER

CSC SUBMISSION REFERENCE

**SD-3010**

No. 3 OF 4 PLANS  
ASCON GRID NUMBER  
**36474**

REV. **A**



DRAWING REVISIONS		REFERENCE DRAWINGS		DESIGNED		THIS WORK WAS PREPARED BY:		JOB TITLE		CSC SUBMISSION REFERENCE	
REV.	REVISION DESCRIPTION	DRG. No.	DESCRIPTION	CONSTRUCT. No.	DATE	DATE	BY	DATE	NO. OF PLANS	SD-3010	REV.
AA	COUNCIL APPROVAL			SURVEY FILE No.	18/08/09	18/08/09	JP	18/08/09	4		A
				FIELD BOOK							
				LOG BOOK							
				LEVEL DATUM	RL:0.994m						
				DATUM	PSM 107268						
SCALE 1:500							ORIGINAL SIZE A1				
									<b>MORAYFIELD REGIONAL COUNCIL</b> CABOULTURE DISTRICT OFFICE 2 HASTING STREET CABOULTURE QLD 4510 Telephone: (07) 5433 0100 Fax: (07) 5433 4000		
THIS WORK WAS PREPARED BY:									163 PETERSEN ROAD MORAYFIELD "AS CONSTRUCTED" - WATER		
									No. 4 OF 4 PLANS ASCON GRID NUMBER <b>36641</b>		