

LOCATION	CITRONELLA ST CH 0-END
SURFACE	4.0mm AC
CBR	15
BASE GR2.1	100
SUBBASE GR2.3	100
L. SUBBASE GR2.5	-

DRAWING REVISIONS		REFERENCE DRAWINGS		DESIGN FILE No.	DESIGNED	---
REV.	REVISION DESCRIPTION	DRG. No.	DESCRIPTION	CONSTRUCT. No.	DATE	NOV 08
				SURVEY FILE No.	DRAWN	BH
				FIELD BOOK	DATE	
				LOG BOOK	CHECKED	JMPH
				LEVEL DATUM	A.H.D.	DATE
				DATUM		

THIS WORK WAS PREPARED BY:
HENDRIKS/HOUSE (CAB)

SCALE 1:500 ORIGINAL SIZE A1

MORTON BAY REGIONAL COUNCIL
 CABOOLTURE DISTRICT OFFICE
 2 HASKING STREET CABOOLTURE QLD 4510
 PO BOX 159 CABOOLTURE QLD 4510
 Telephone: (07) 5420 0100
 Fax: (07) 5420 0188

**COACHWOOD RISE ESTATE,
 STAGE 6B & 6C, MORAYFIELD**

**"AS CONSTRUCTED"
 STORMWATER**

MBRC SUBDIVISION REFERENCE	
OPW-2006-793	
No. 1 OF 9 PLANS	
DRAWING NUMBER	REV.
36150	




LOCATION	LEMON MYRTLE DR CH 0-END
SURFACE	40mm AC
CBR	3
BASE GR2.1	100
SUBBASE GR2.3	100
L. SUBBASE GR2.5	290

LOCATION	LIVISTONA CRT CH 0-END
SURFACE	25mm AC
CBR	3
BASE GR2.1	100
SUBBASE GR2.3	100
L. SUBBASE GR2.5	230

LOCATION	CITRONELLA ST CH 0-END
SURFACE	40mm AC
CBR	15
BASE GR2.1	100
SUBBASE GR2.3	100
L. SUBBASE GR2.5	-

LOCATION	ACEMIA DR CH 0-END
SURFACE	40mm AC
CBR	3.5
BASE GR2.1	100
SUBBASE GR2.3	100
L. SUBBASE GR2.5	250

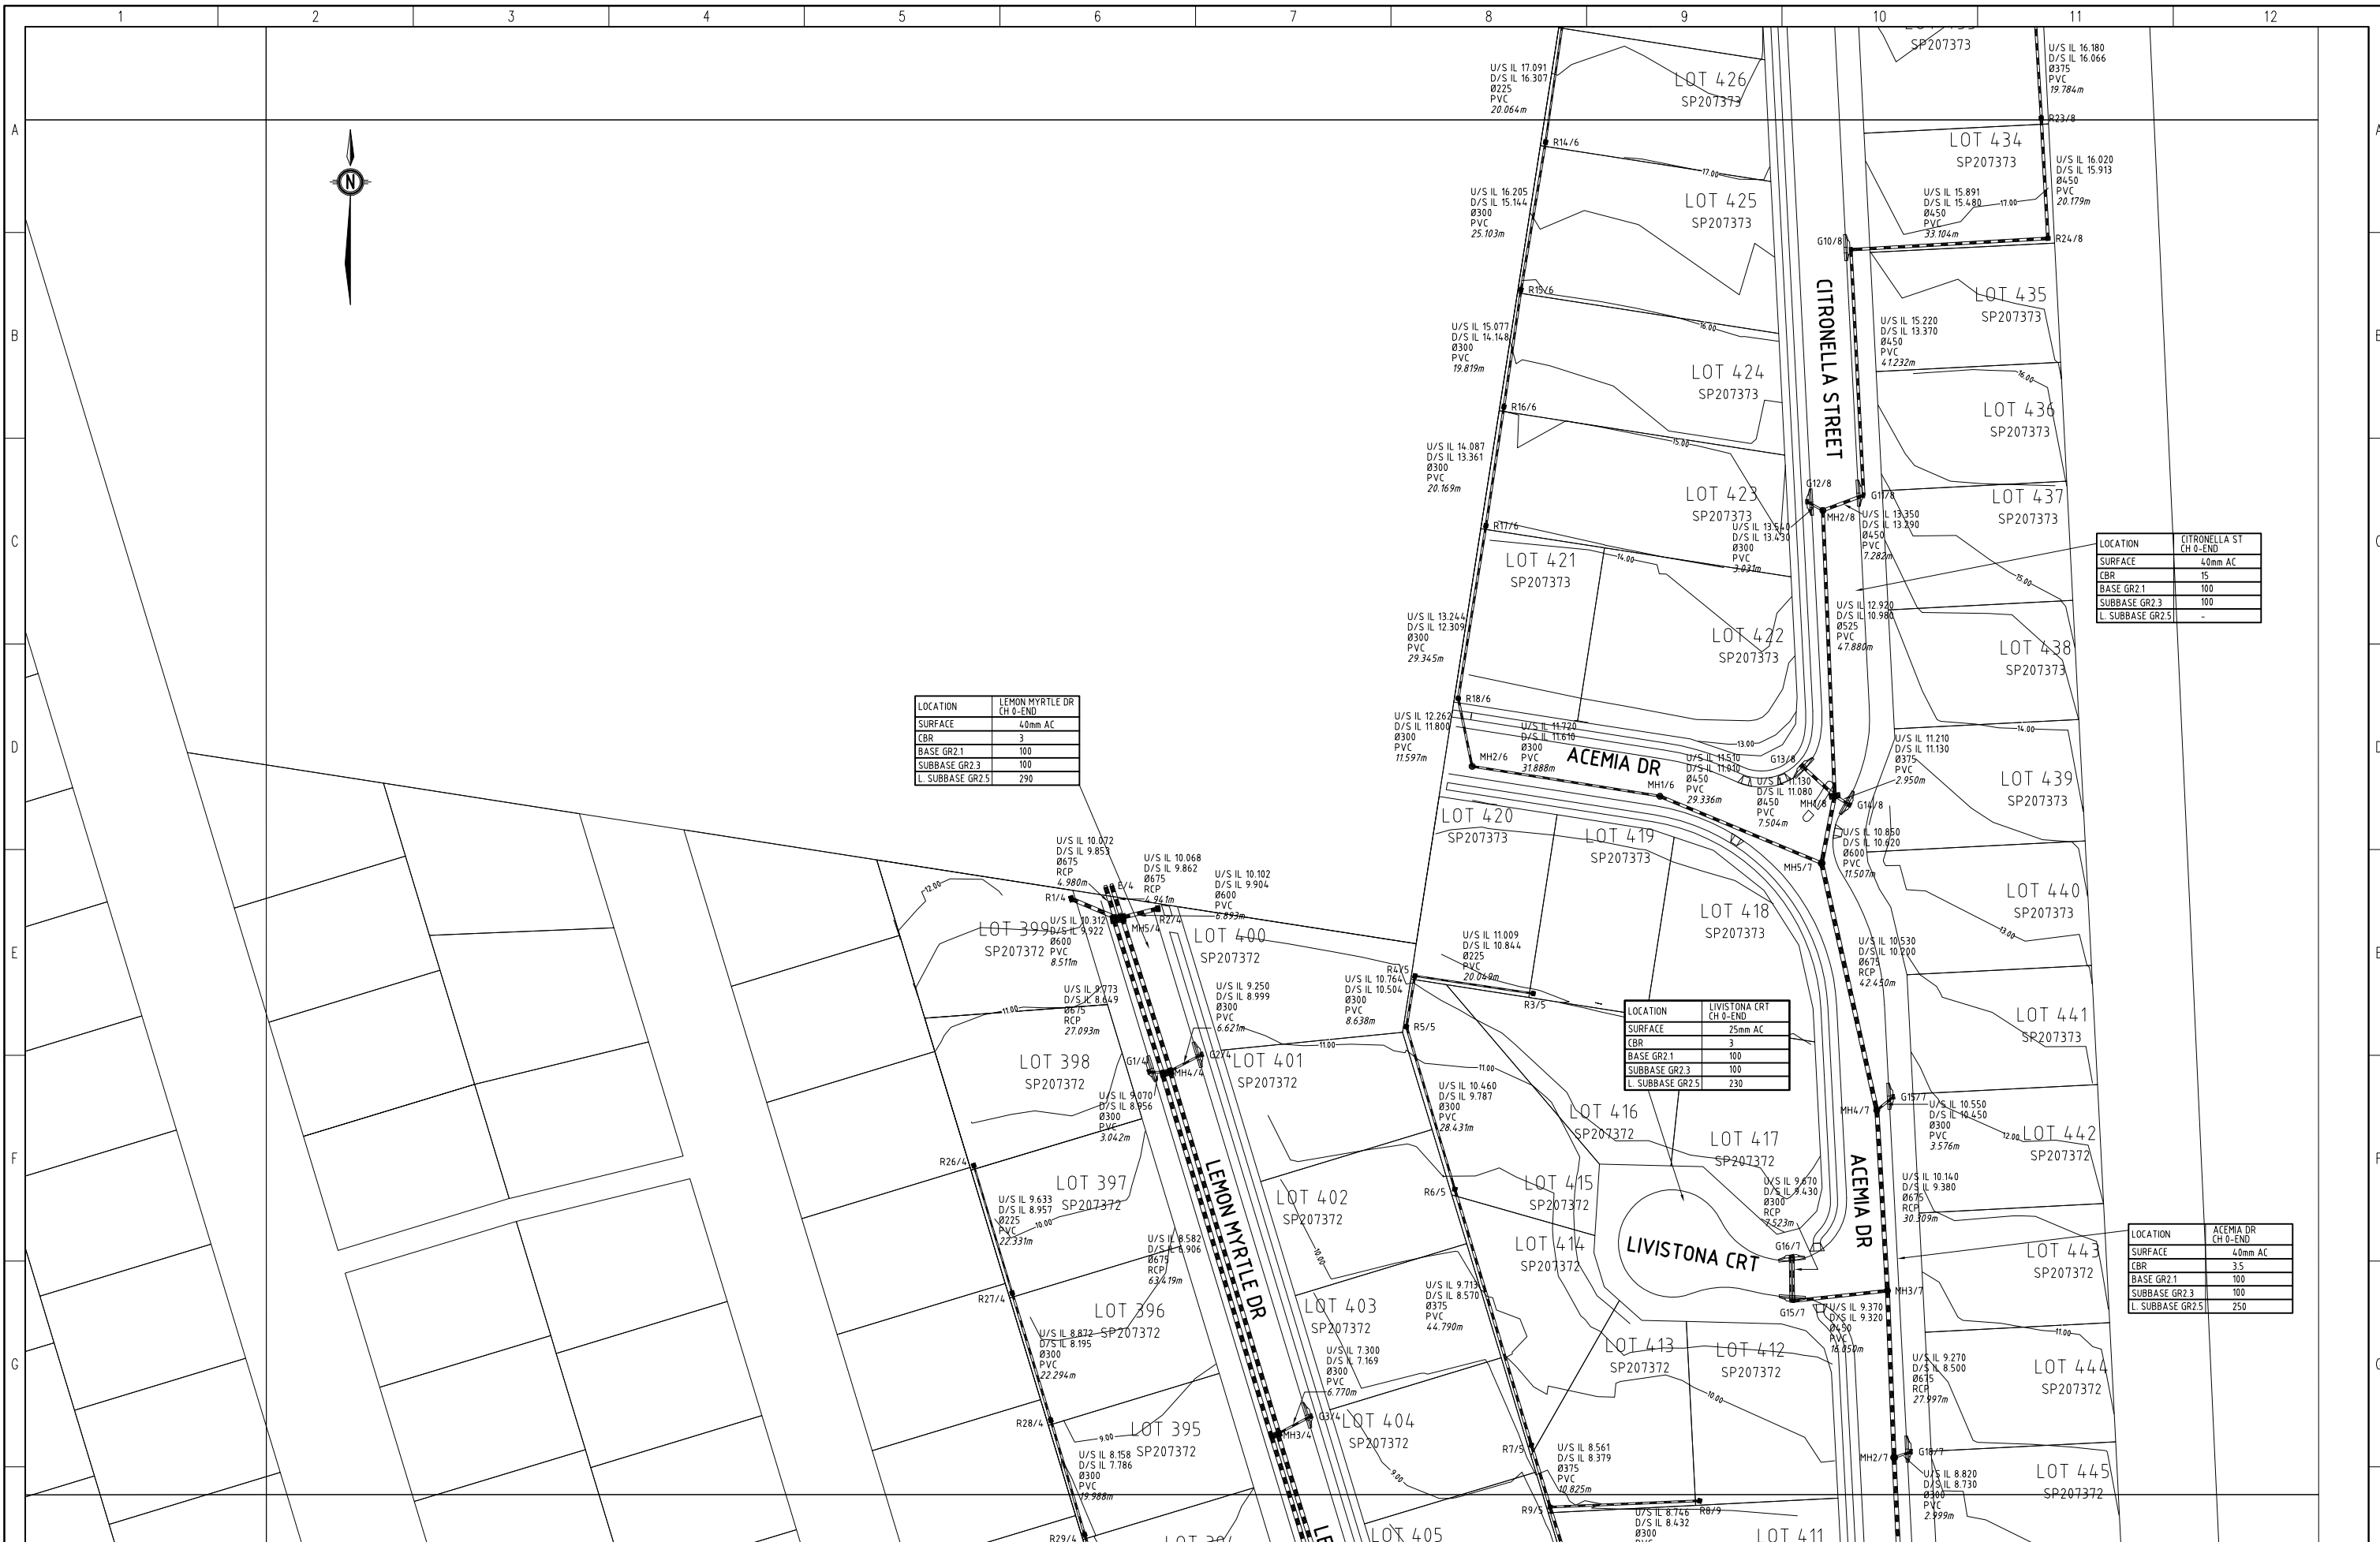

DRAWING REVISIONS		REFERENCE DRAWINGS		DESIGN FILE No.	DESIGNED	DATE
REV.	REVISION DESCRIPTION	DRG. No.	DESCRIPTION	CONSTRUCT. No.	DATE	NOV 08
				SURVEY FILE No.	DRAWN	BH
				FIELD BOOK	DATE	
				LOG BOOK	CHECKED	JMPH
				LEVEL DATUM	A.H.D.	DATE
				DATUM		

THIS WORK WAS PREPARED BY:
HENDRIKS/HOUSE (CAB)


SCALE 1:500 ORIGINAL SIZE A1

MORTON BAY REGIONAL COUNCIL
 CABOOLTURE DISTRICT OFFICE
 2 HASKING STREET CABOOLTURE QLD 4510
 PO BOX 159 CABOOLTURE QLD 4510
 Telephone: (07) 5420 0100
 Fax: (07) 5420 0188

**COACHWOOD RISE ESTATE,
 STAGE 6B & 6C, MORAYFIELD**

**"AS CONSTRUCTED"
 STORMWATER**

MBRC SUBDIVISION REFERENCE	
OPW-2006-793	
No. 2 OF 9 PLANS	
DRAWING NUMBER	REV.
36317	

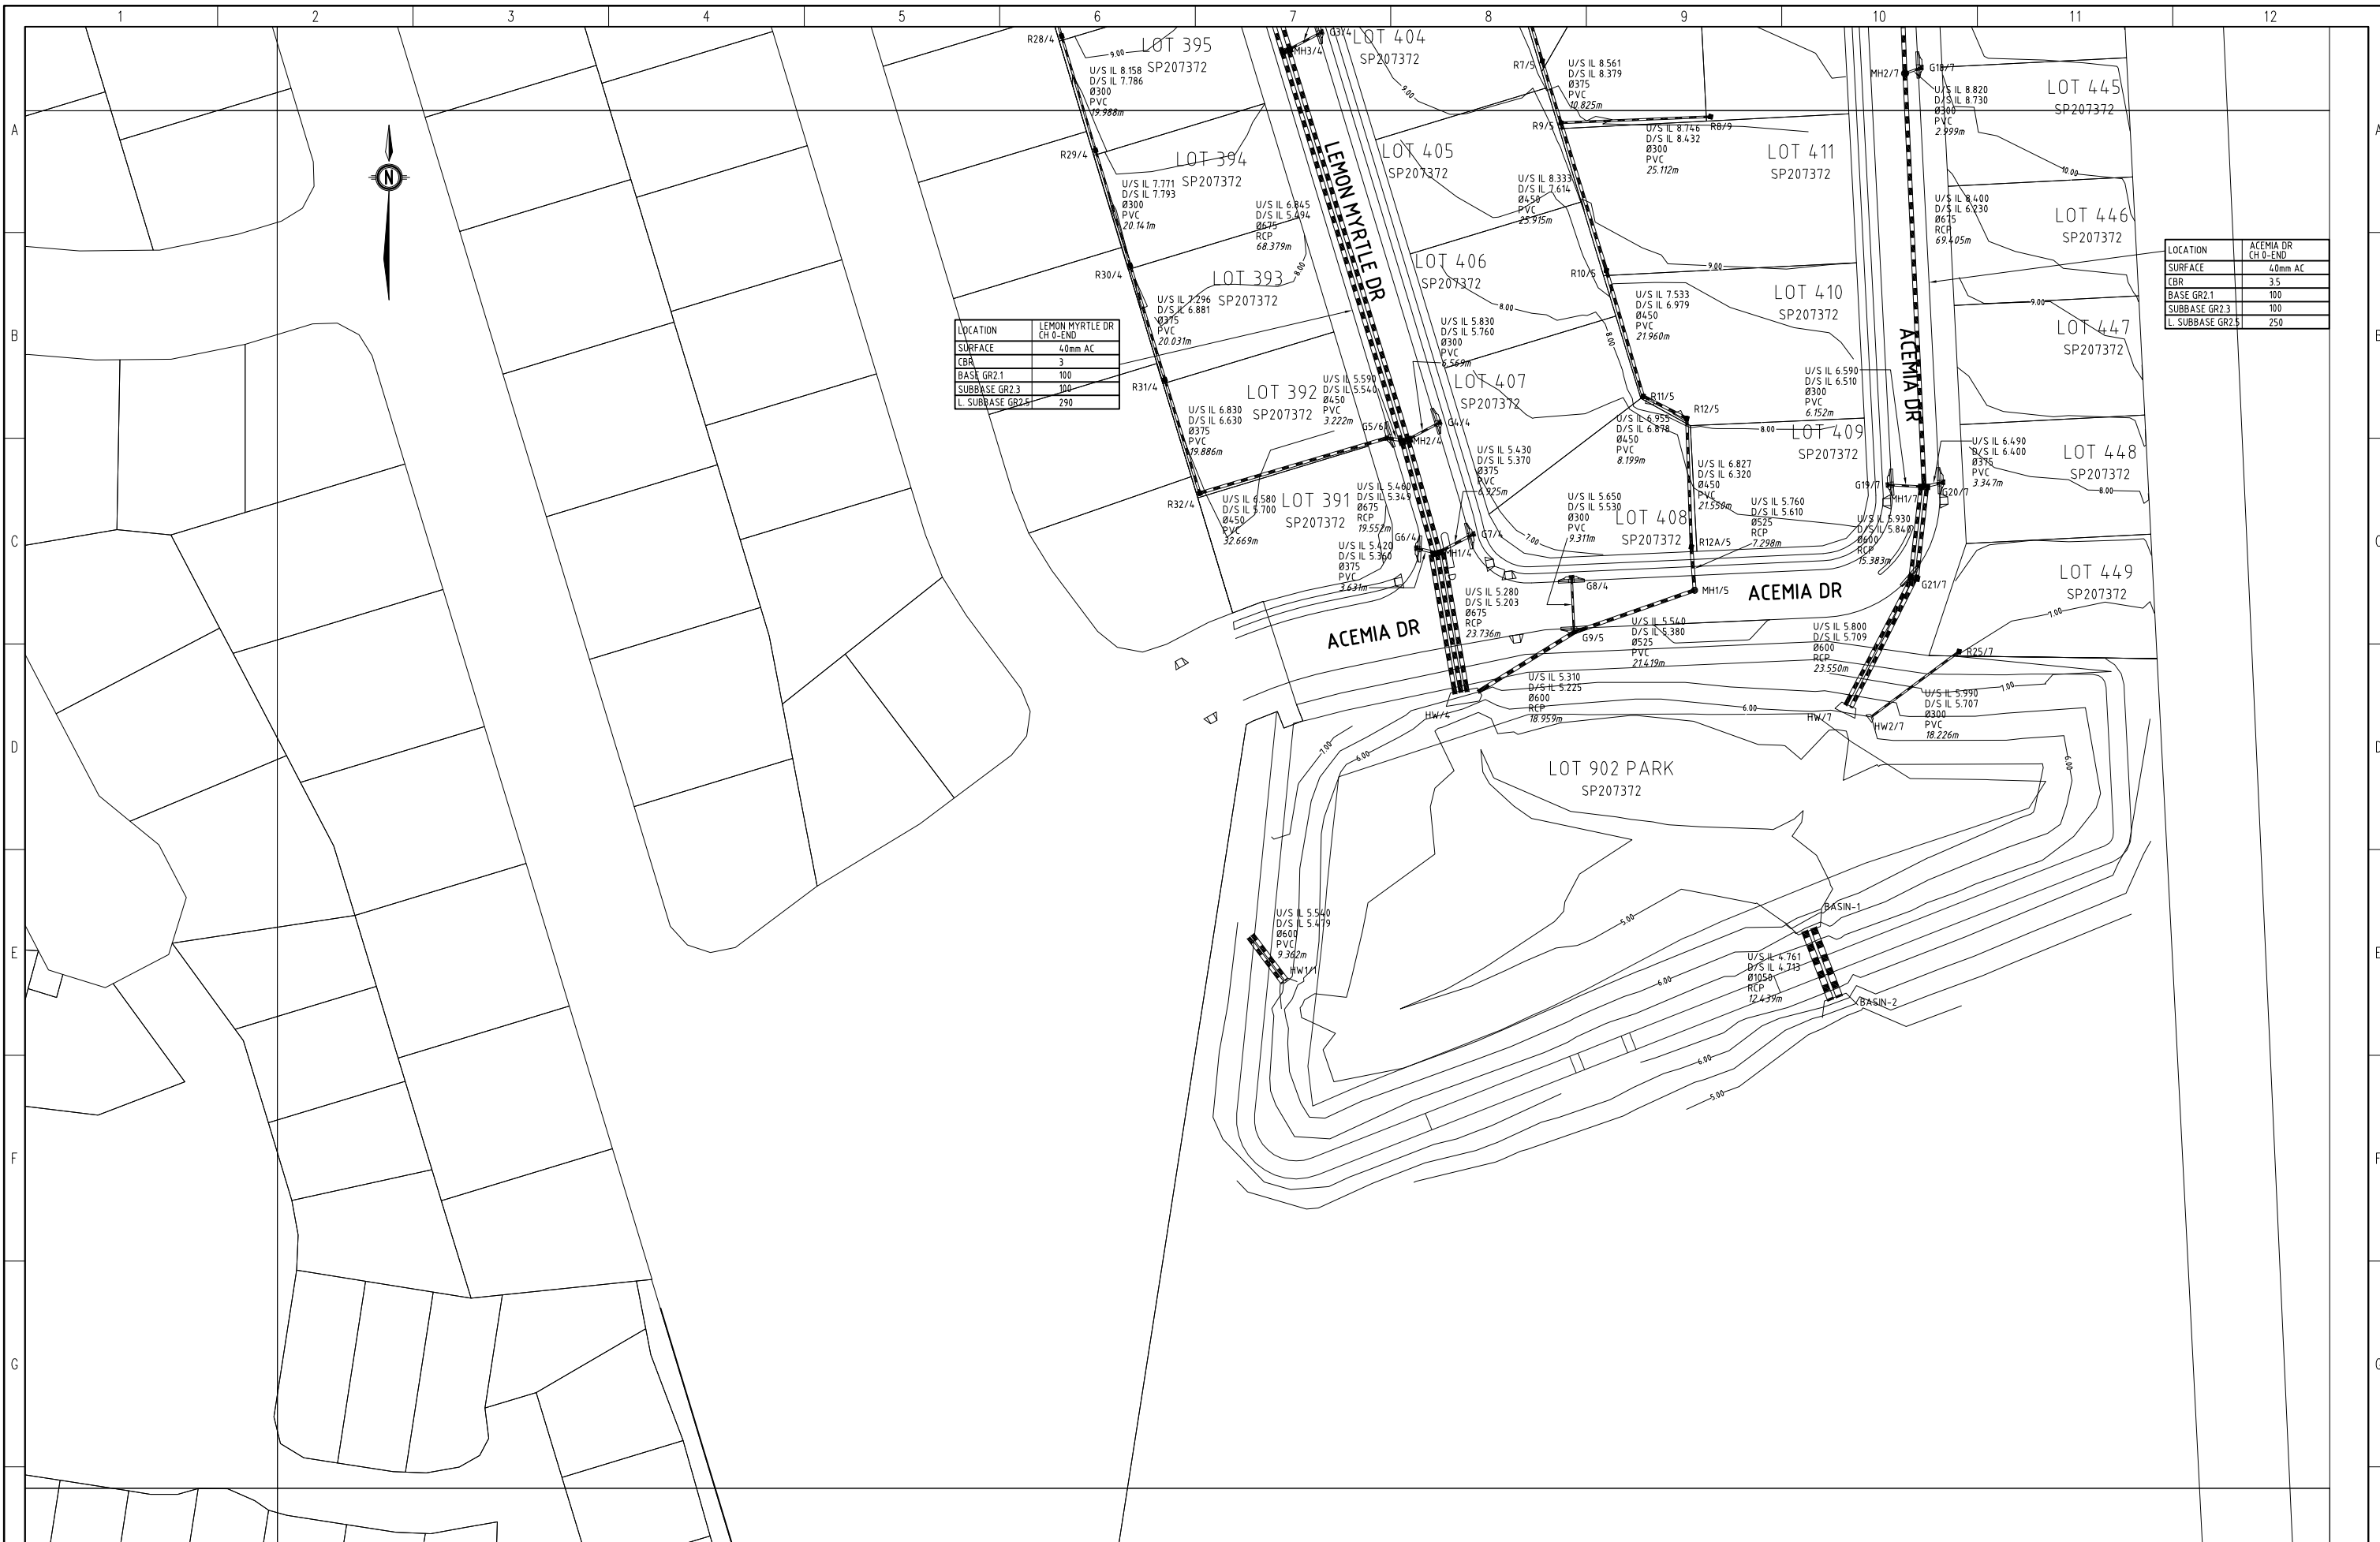


LOCATION	LEMON MYRTLE DR CH 0-END
SURFACE	40mm AC
CBR	3
BASE GR2.1	100
SUBBASE GR2.3	100
L. SUBBASE GR2.5	290

LOCATION	ACEMIA DR CH 0-END
SURFACE	40mm AC
CBR	3.5
BASE GR2.1	100
SUBBASE GR2.3	100
L. SUBBASE GR2.5	250

DRAWING REVISIONS		REFERENCE DRAWINGS		DESIGN FILE No.	DESIGNED	---
REV.	REVISION DESCRIPTION	DRG. No.	DESCRIPTION	CONSTRUCT. No.	DATE	NOV 08
				SURVEY FILE No.	DRAWN	BH
				FIELD BOOK	DATE	
				LOG BOOK	CHECKED	JMPH
				LEVEL DATUM	A.H.D.	DATE
				DATUM		

THIS WORK WAS PREPARED BY:
HENDRIKS/HOUSE (CAB)



SCALE 1:500 ORIGINAL SIZE A1

MORTON BAY REGIONAL COUNCIL
 CABOOLTURE DISTRICT OFFICE
 2 HASKING STREET CABOOLTURE QLD 4510
 PO BOX 159 CABOOLTURE QLD 4510
 Telephone: (07) 5420 0100
 Fax: (07) 5420 0188

**COACHWOOD RISE ESTATE,
 STAGE 6B & 6C, MORAYFIELD**

"AS CONSTRUCTED"
STORMWATER

MBRC SUBDIVISION REFERENCE	
OPW-2006-793	
No. 3 OF 9 PLANS	
DRAWING NUMBER	REV.
36484	



LOT 904-PARK
SP207373

LOT 429
SP207373

HCB 2135
OFFSET 153
Stub
SL 18.437
IL 17.229
SO_SIDE 1.646
SO_OTHER 2.919

2/E
SL 18.437

UIL 17.229
DIL 16.700
Ø150
uPVC
21537
Type 1
SN8 (SEH)

2/10
SL 18.200

1.5m

HCB 44.71
OFFSET 0.36
Sloped Branch
SL 17.530
IL 16.442
SO_SIDE 1.284
SO_OTHER 1.722

UIL 16.650
DIL 14.100
Ø150
uPVC
64.750
Type 1
SN8 (SEH)

HCB 25.13
OFFSET 0.25
Sloped Branch
SL 16.853
IL 15.621
SO_SIDE 1.444
SO_OTHER 1.775

LOT 430
SP207373

HCB 0.00
OFFSET 1.39
Stub
SL 17.753
IL 16.117
SO_SIDE 1.942
SO_OTHER 2.581

1/11
SL 17.753

LOT 431
SP207373

HCB 62.02
OFFSET 0.29
Jump Up
SL 17.487
IL 16.234
SO_SIDE 1.420
SO_OTHER 1.714

LOT 432
SP207373

UIL 15.962
DIL 14.866
Ø150
uPVC
Ø1926
Type 1
SN8 (SEH)

HCB 42.43
OFFSET 0.15
Jump Up
SL 17.224
IL 15.924
SO_SIDE 1.563
SO_OTHER 1.804

LOT 433
SP207373

HCB 21.91
OFFSET 0.27
Jump Up
SL 16.953
IL 15.652
SO_SIDE 1.294
SO_OTHER 1.793

15m

LOT 434
SP207373

HCB 2.23
OFFSET 0.11
Jump Up

CITRONELLA STREET

DRAWING REVISIONS		REFERENCE DRAWINGS		DESIGN FILE No.	DESIGNED	---
REV.	REVISION DESCRIPTION	DRG. No.	DESCRIPTION	CONSTRUCT. No.	DATE	NOV 08
				SURVEY FILE No.	DRAWN	BH
				FIELD BOOK	DATE	
				LOG BOOK	CHECKED	JMPH
				LEVEL DATUM	A.H.D.	DATE
				DATUM		

THIS WORK WAS PREPARED BY:
HENDRIKS/HOUSE (CAB)



MORTON BAY REGIONAL COUNCIL
CABOOLTURE DISTRICT OFFICE
2 HASKING STREET CABOOLTURE QLD 4510
PO BOX 159 CABOOLTURE QLD 4510
Telephone: (07) 5420 0100
Fax: (07) 5420 0188

**COACHWOOD RISE ESTATE,
STAGE 6B & 6C, MORAYFIELD**

"AS CONSTRUCTED"
SEWER

MBRC SUBDIVISION REFERENCE	
OPW-2006-793	
No. 4 OF 9 PLANS	
DRAWING NUMBER	REV.
36150	

SCALE 1:500 ORIGINAL SIZE A1



DRAWING REVISIONS		REFERENCE DRAWINGS		DESIGN FILE No.	DESIGNED	DATE
REV.	REVISION DESCRIPTION	DRG. No.	DESCRIPTION	CONSTRUCT. No.	DATE	NOV 08
				SURVEY FILE No.	DRAWN	BH
				FIELD BOOK	DATE	
				LOG BOOK	CHECKED	JMPH
				LEVEL DATUM	A.H.D.	DATE
				DATUM		

THIS WORK WAS PREPARED BY:
HENDRIKS/HOUSE (CAB)

SCALE 1:500 ORIGINAL SIZE A1

MORTON BAY REGIONAL COUNCIL
 CABOOLTURE DISTRICT OFFICE
 2 HASKING STREET CABOOLTURE QLD 4510
 PO BOX 159 CABOOLTURE QLD 4510
 Telephone: (07) 5420 0100
 Fax: (07) 5420 0188

**COACHWOOD RISE ESTATE,
 STAGE 6B & 6C, MORAYFIELD**

**"AS CONSTRUCTED"
 SEWER**

MBRC SUBDIVISION REFERENCE	
OPW-2006-793	
No. 5 OF 9 PLANS	
DRAWING NUMBER	REV.
36317	



DRAWING REVISIONS		REFERENCE DRAWINGS		DESIGN FILE No.	DESIGNED	DATE
REV.	REVISION DESCRIPTION	DRG. No.	DESCRIPTION	CONSTRUCT. No.	DATE	NOV 08
				SURVEY FILE No.	DRAWN	BH
				FIELD BOOK	DATE	
				LOG BOOK	CHECKED	JMPH
				LEVEL DATUM	A.H.D.	DATE
				DATUM		

THIS WORK WAS PREPARED BY:
HENDRIKS/HOUSE (CAB)


SCALE 1:500 ORIGINAL SIZE A1

MORTEON BAY REGIONAL COUNCIL
 CABOOLTURE DISTRICT OFFICE
 2 HASKING STREET CABOOLTURE QLD 4510
 PO BOX 159 CABOOLTURE QLD 4510
 Telephone: (07) 5420 0100
 Fax: (07) 5420 0188

**COACHWOOD RISE ESTATE,
 STAGE 6B & 6C, MORAYFIELD**

"AS CONSTRUCTED"
SEWER

MBRC SUBDIVISION REFERENCE	
OPW-2006-793	
No. 6 OF 9 PLANS	
DRAWING NUMBER	REV.
36484	

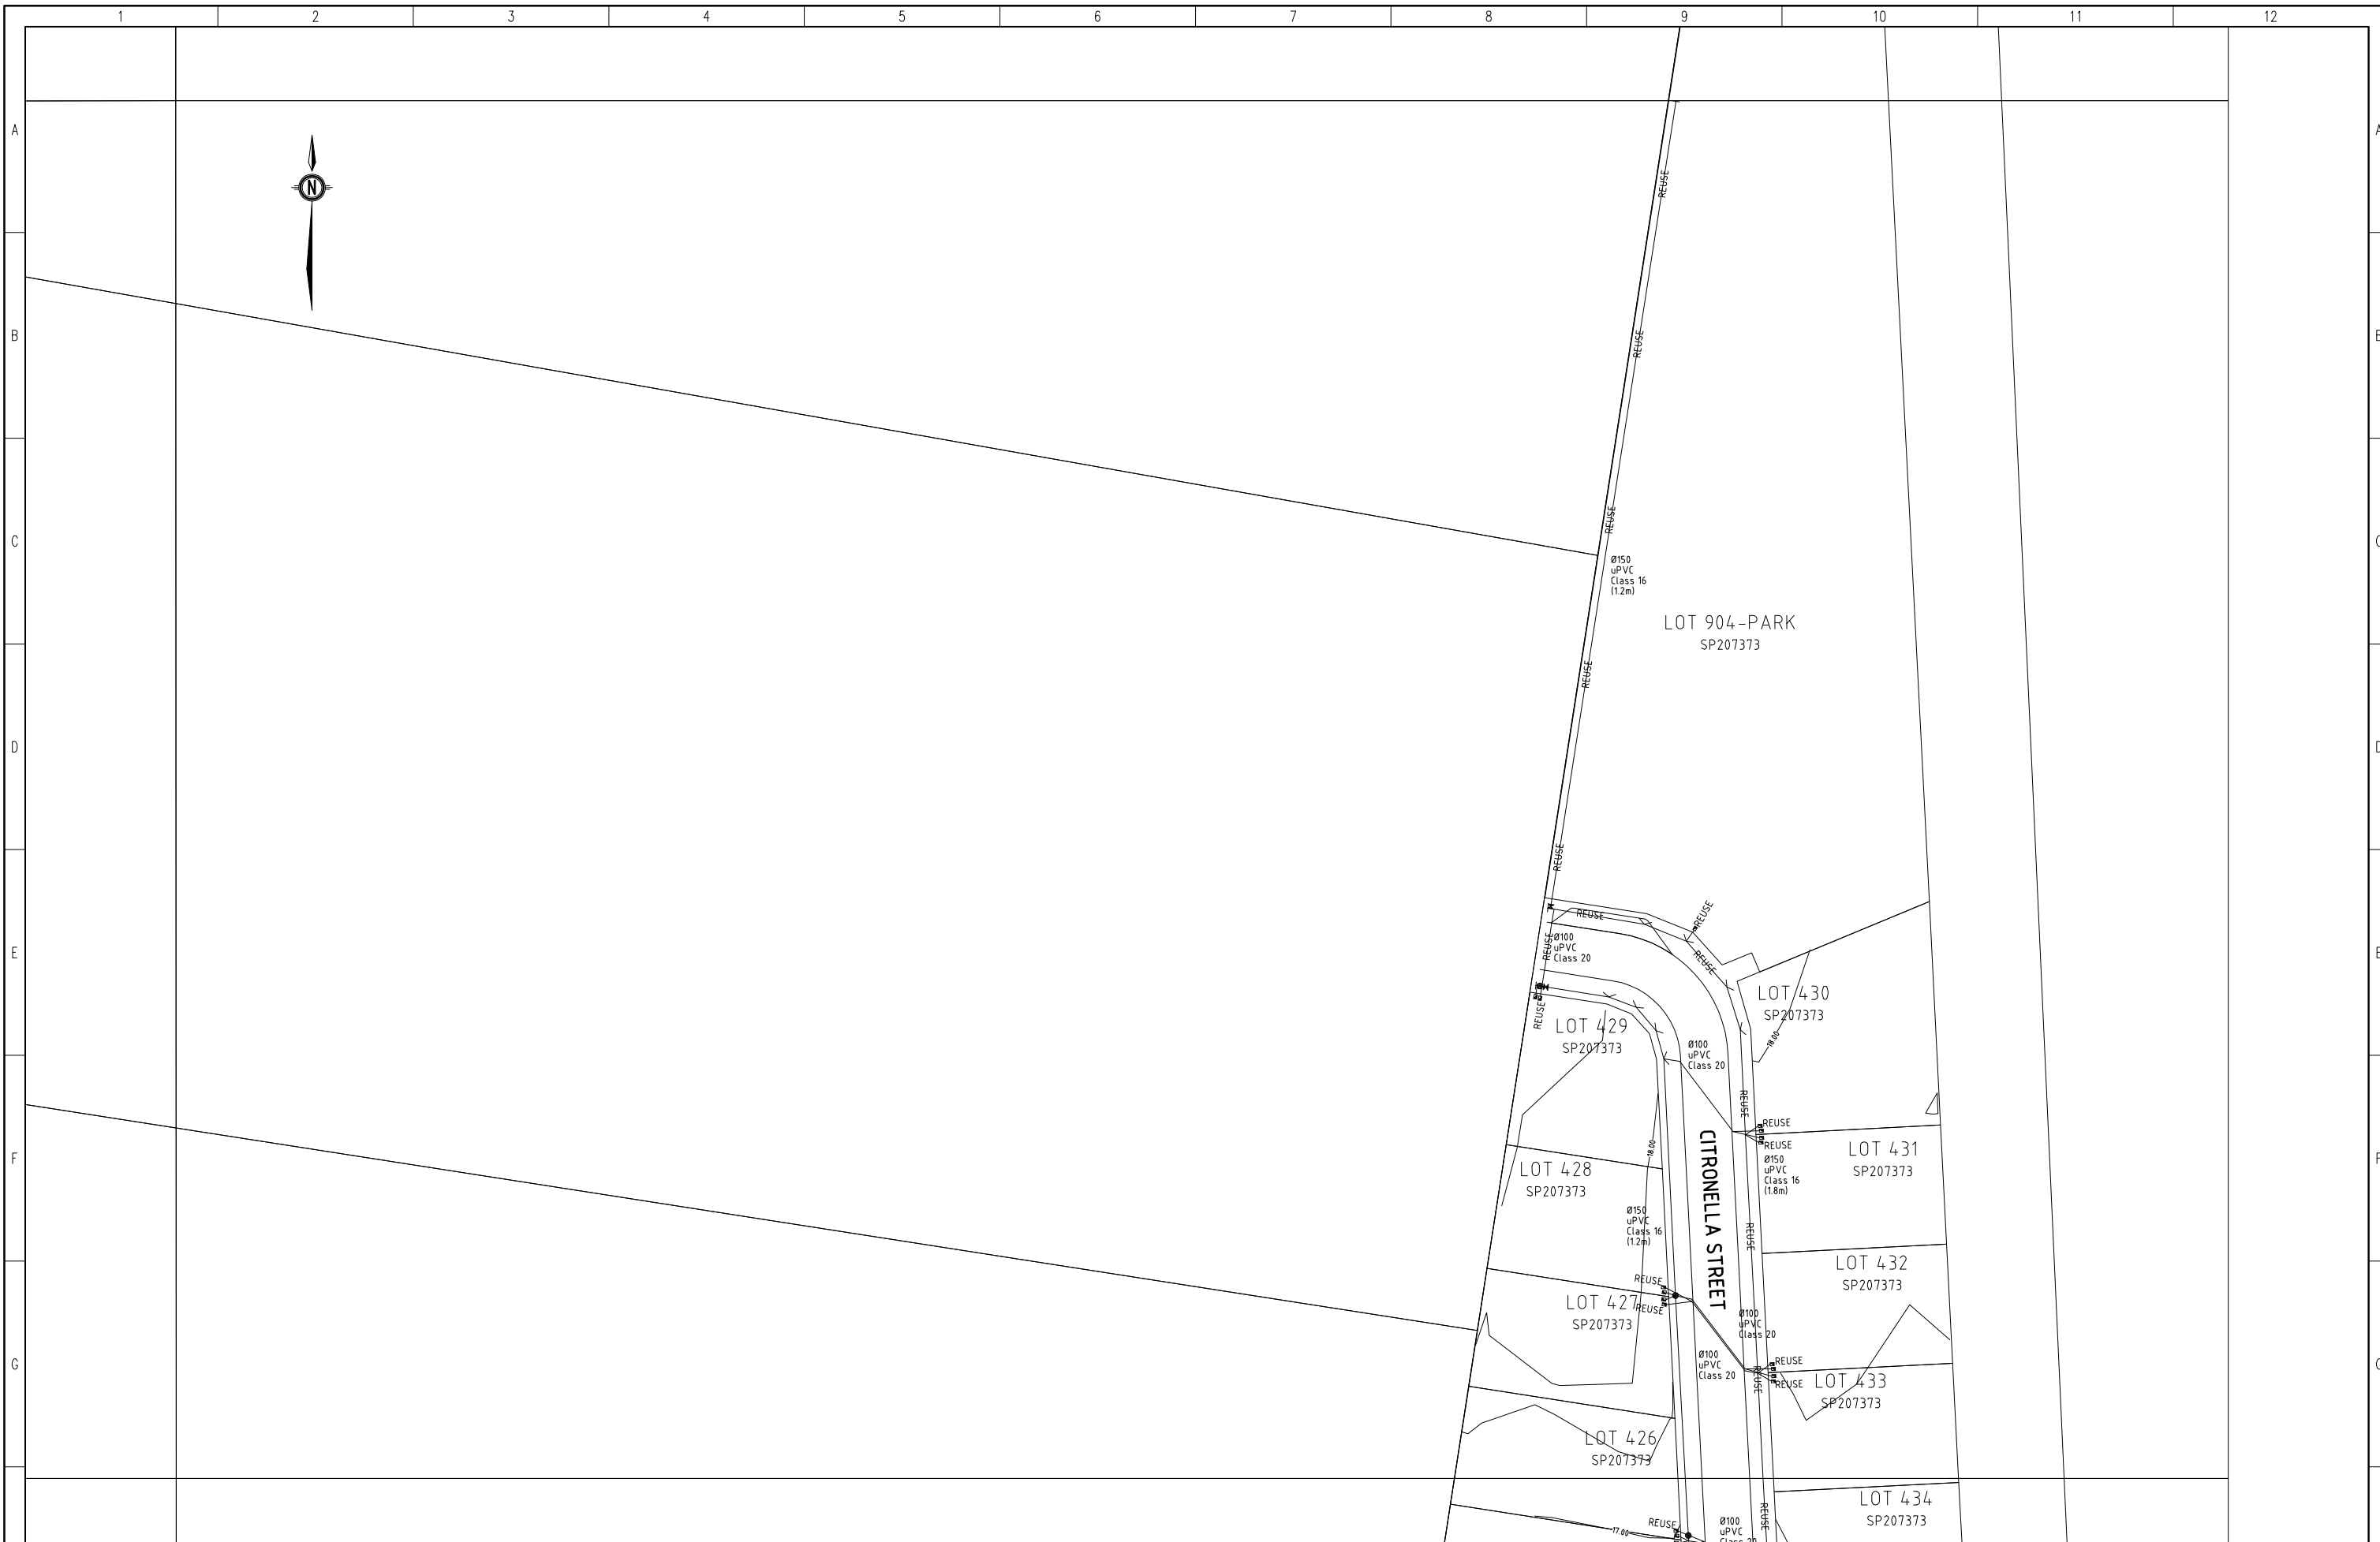

DRAWING REVISIONS		REFERENCE DRAWINGS		DESIGN FILE No.	DESIGNED	DATE
REV.	REVISION DESCRIPTION	DRG. No.	DESCRIPTION	CONSTRUCT. No.	DATE	NOV 08
				FIELD BOOK	DRAWN	BH
				LOG BOOK	CHECKED	JMPH
				LEVEL DATUM	A.H.D.	DATE
				DATUM		

THIS WORK WAS PREPARED BY:
HENDRIKS/HOUSE (CAB)


SCALE 1:500 ORIGINAL SIZE A1

MORTON BAY REGIONAL COUNCIL
 CABOOLTURE DISTRICT OFFICE
 2 HASKING STREET CABOOLTURE QLD 4510
 PO BOX 159 CABOOLTURE QLD 4510
 Telephone: (07) 5420 0100
 Fax: (07) 5420 0188

**COACHWOOD RISE ESTATE,
 STAGE 6B & 6C, MORAYFIELD**

"AS CONSTRUCTED"
WATER

MBRC SUBDIVISION REFERENCE	
OPW-2006-793	
No. 7 OF 9 PLANS	
DRAWING NUMBER	REV.
36150	

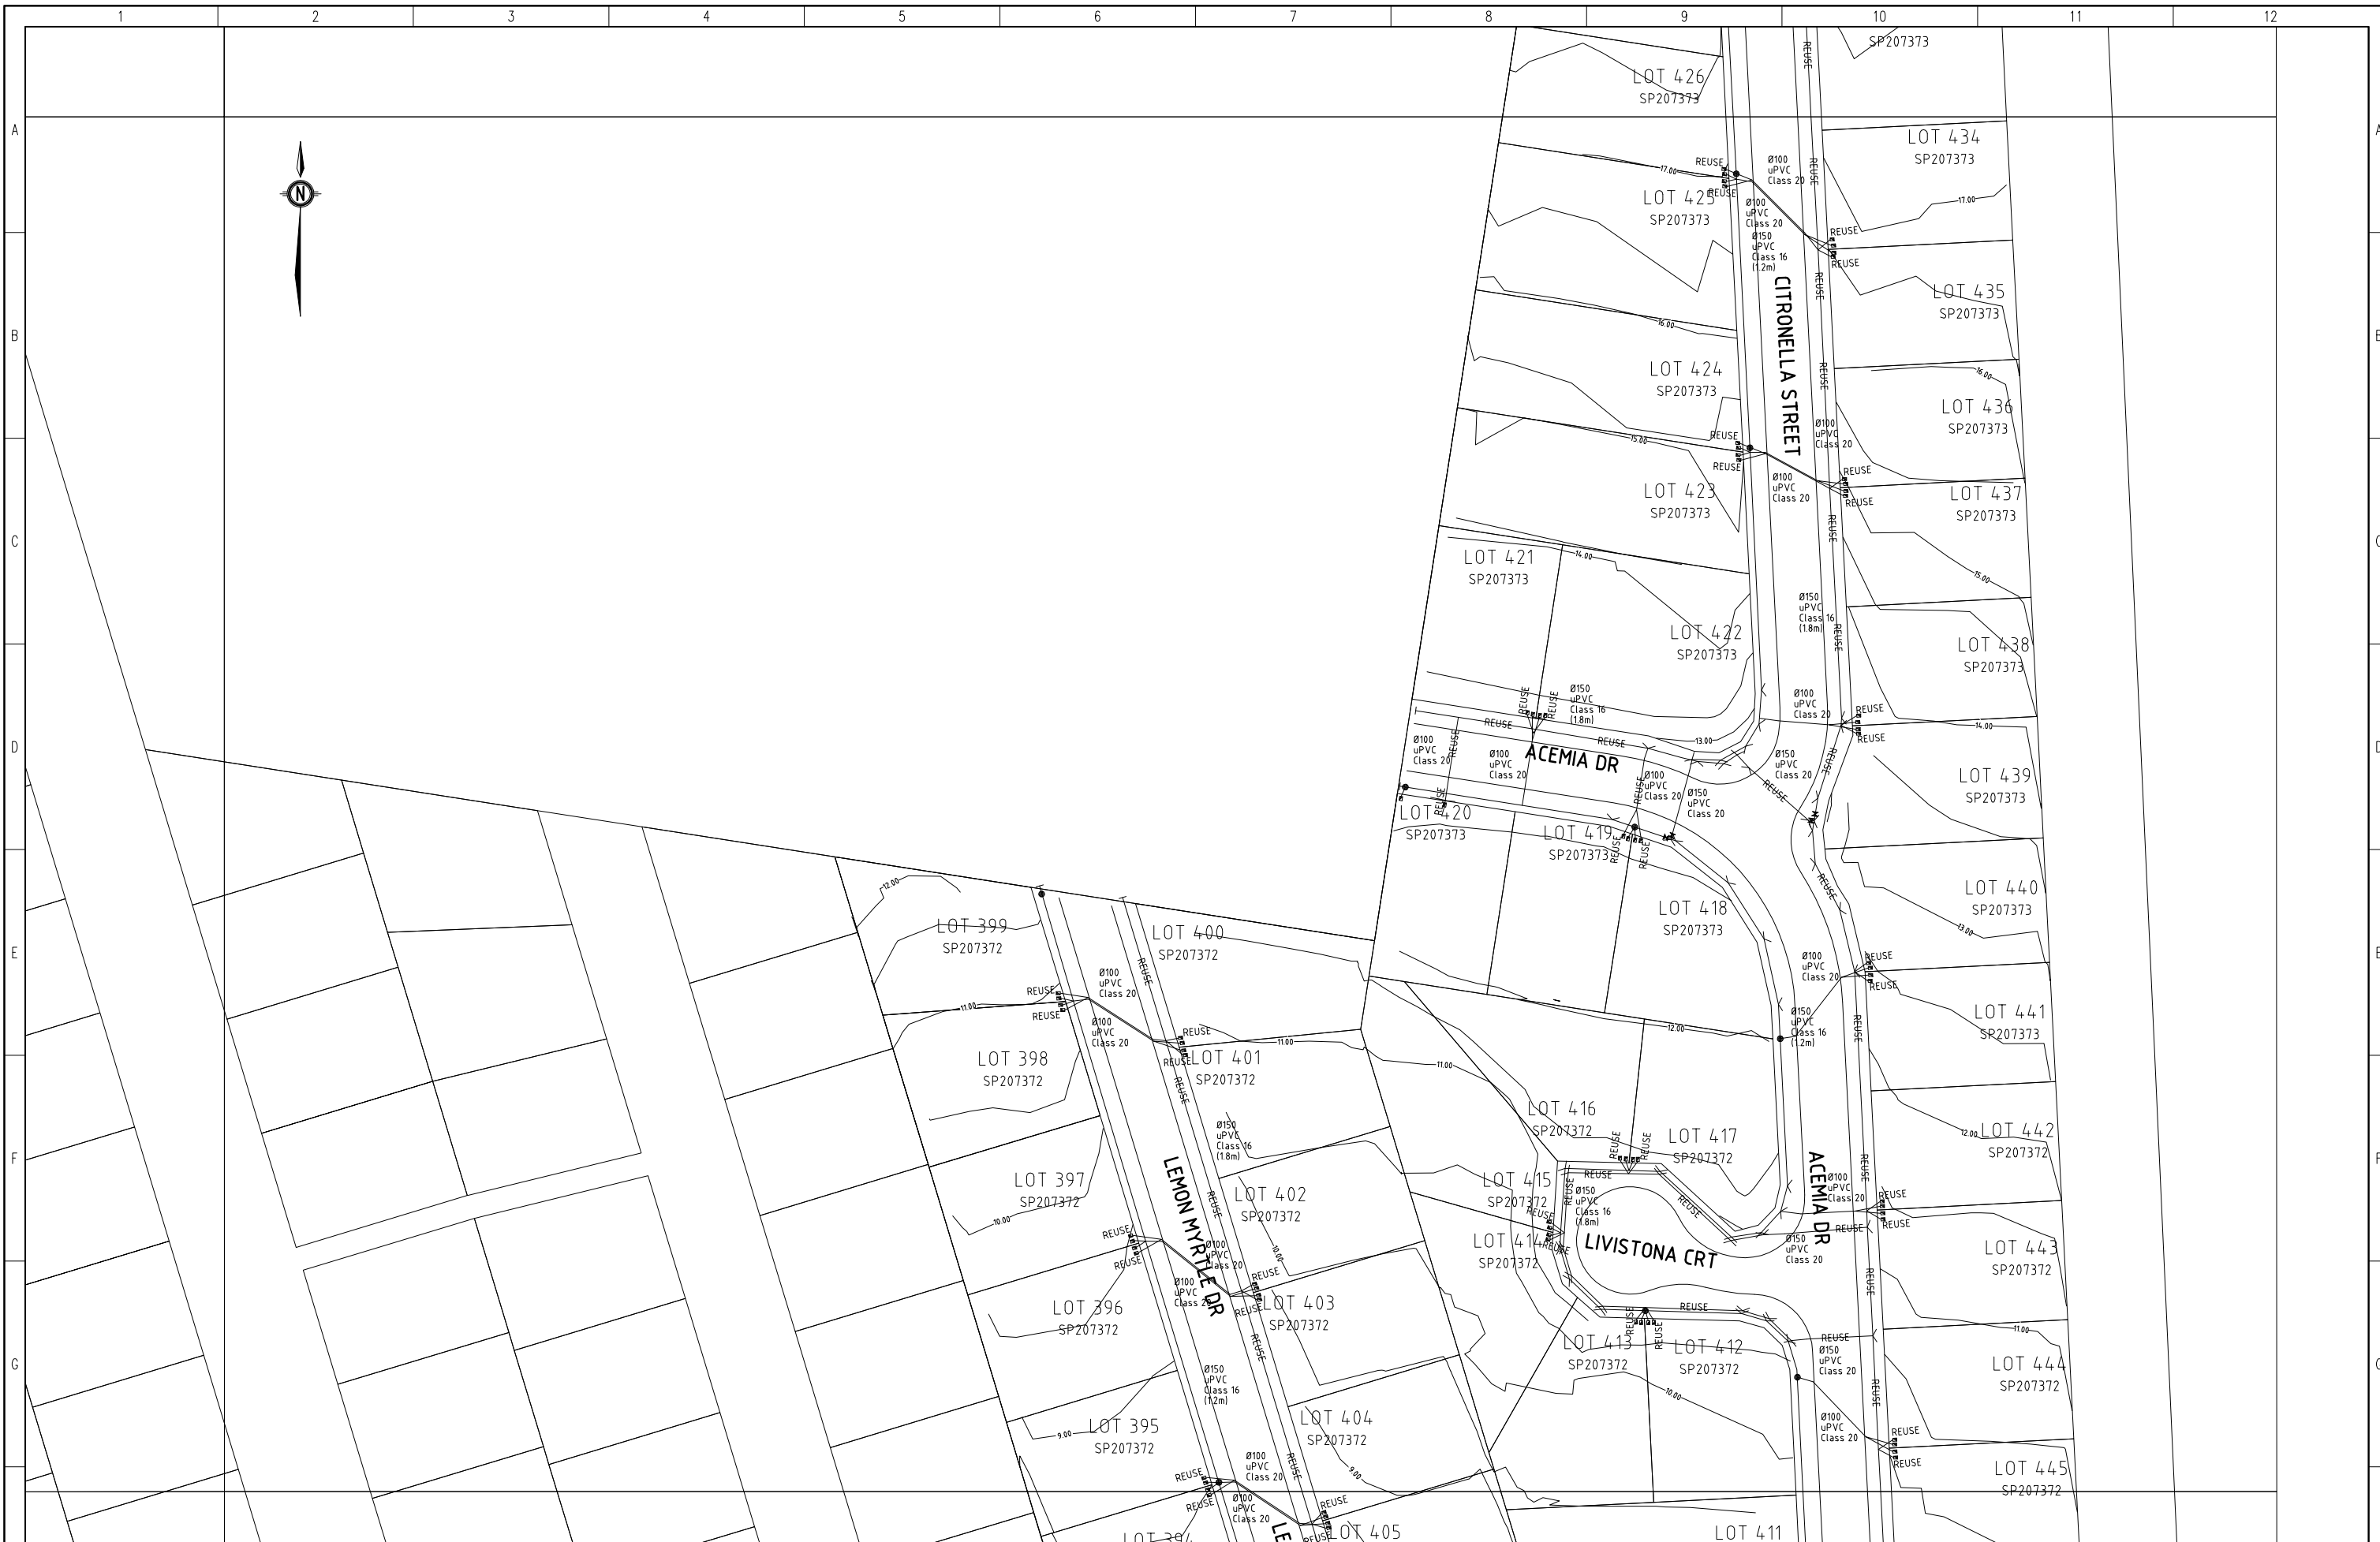

DRAWING REVISIONS		REFERENCE DRAWINGS		DESIGN FILE No.	DESIGNED	DATE
REV.	REVISION DESCRIPTION	DRG. No.	DESCRIPTION	CONSTRUCT. No.	DATE	NOV 08
				SURVEY FILE No.	DRAWN	BH
				FIELD BOOK	DATE	
				LOG BOOK	CHECKED	JMPH
				LEVEL DATUM	A.H.D.	DATE
				DATUM		

THIS WORK WAS PREPARED BY:
HENDRIKS/HOUSE (CAB)

SCALE 1:500 ORIGINAL SIZE A1



MORTON BAY REGIONAL COUNCIL
 CABOOLTURE DISTRICT OFFICE
 2 HASKING STREET CABOOLTURE QLD 4510
 PO BOX 159 CABOOLTURE QLD 4510
 Telephone: (07) 5420 0100
 Fax: (07) 5420 0188

**COACHWOOD RISE ESTATE,
 STAGE 6B & 6C, MORAYFIELD**

"AS CONSTRUCTED"
WATER

MBRC SUBDIVISION REFERENCE	
OPW-2006-793	
No. 8 OF 9 PLANS	
DRAWING NUMBER	REV.
36317	



DRAWING REVISIONS		REFERENCE DRAWINGS		DESIGN FILE No.	DESIGNED	---
REV.	REVISION DESCRIPTION	DRG. No.	DESCRIPTION	CONSTRUCT. No.	DATE	NOV 08
				SURVEY FILE No.	DRAWN	BH
				FIELD BOOK	DATE	
				LOG BOOK	CHECKED	JMPH
				LEVEL DATUM	A.H.D.	DATE
				DATUM		

THIS WORK WAS PREPARED BY:
HENDRIKS/HOUSE (CAB)

SCALE 1:500 ORIGINAL SIZE A1

MORTON BAY REGIONAL COUNCIL
 CABOOLTURE DISTRICT OFFICE
 2 HASKING STREET CABOOLTURE QLD 4510
 PO BOX 159 CABOOLTURE QLD 4510
 Telephone: (07) 5420 0100
 Fax: (07) 5420 0188

**COACHWOOD RISE ESTATE,
 STAGE 6B & 6C, MORAYFIELD**

"AS CONSTRUCTED"
WATER

MBRC SUBDIVISION REFERENCE	
OPW-2006-793	
No. 9 OF 9 PLANS	
DRAWING NUMBER	REV.
36484	